

In accordance with Comm 85, Wis. Adm. Code

Attach complete site plan on paper not less than 8 1/2 x 11 inches in size. Plan must include, but not limited to: vertical and horizontal reference point (BM), direction and percent slope, scale or dimensions, north arrow, and location and distance to nearest road.

Please print all information.

Personal information you provide may be used for secondary purposes (Privacy Law, s. 15.04 (1) (m)).

County	JEFFERSON
Parcel I.D.	002-0714-3522-012
Reviewed by	Date

Property Owner KENN BLOCK	Property Location Govt. Lot NW 1/4 NW 1/4 S25 T 7 N R 14 E (D)W		
Property Owner's Mailing Address 270 E. FIELDCREST LANE	Lot # 18	Block #	Subd. Name or GEM# FIRST ADDITION TO ROCKRIDGE
City ORO VALLEY	State AZ	Zip Code 85737	Phone Number (520) 575-1340
<input type="checkbox"/> City		<input type="checkbox"/> Village	<input checked="" type="checkbox"/> Town
Nearest Road AZTALAN		BIEDERMAN ROAD	

New Construction Use: Residential / Number of bedrooms 3 Code derived design flow rate 450 GPD

Replacement Public or commercial - Describe: _____

Parent material LOESS OVER GLACIAL TILL Flood Plain elevation if applicable NONE ft.

General comments and recommendations: INSTALL CONVENTIONAL SEEPAGE CELLS AS SHOWN ON SITE PLAN. SOIL APPLICATION RATE = 0.4 GPD/FT².

7 Boring # Boring Pit Ground surface elev. 97.3 ft. Depth to limiting factor 84+ in.

Horizon	Depth in.	Dominant Color Munsell	Redox Description Qu. Sz. Cont. Color	Texture	Structure Gr. Sz. Sh.	Consistence	Boundary	Roots	Soil Application Rate GPD/ft ²	
									*Eff#1	*Eff#2
1	0-13	10YR 3/3	-	sil	2f sbk	mfr	CS	3m	0.5	0.8
2	13-39	7.5YR 4/4	-	scl	2m sbk	mfr	CW	2m	0.4	0.6
3	39-84	10YR 6/4	-	sl	Impl	mfr	-	2f	0.4	0.6

8 Boring # Boring Pit Ground surface elev. 97.2 ft. Depth to limiting factor 84+ in.

Horizon	Depth in.	Dominant Color Munsell	Redox Description Qu. Sz. Cont. Color	Texture	Structure Gr. Sz. Sh.	Consistence	Boundary	Roots	Soil Application Rate GPD/ft ²	
									*Eff#1	*Eff#2
1	0-12	10YR 3/3	-	sil	2f sbk	mfr	CS	3m	0.5	0.8
2	12-28	7.5YR 4/4	-	scl	2m sbk	mfr	CW	2m	0.4	0.6
3	28-84	10YR 6/4	-	sl	Impl	mfr	-	2f	0.4	0.6

* Effluent #1 = BOD₅ > 30 ≤ 220 mg/L and TSS > 30 ≤ 150 mg/L

* Effluent #2 = BOD₅ ≤ 30 mg/L and TSS ≤ 30 mg/L

CST Name (Please Print) RICHARD C. HERRO	Signature <i>Richard C. Herro</i>	CST Number CREDENTIAL # 71536
Address 603 N. DEWEY AVE., JEFFERSON, WI 53549	Date Evaluation Conducted 4-28-2001	Telephone Number 920-674-2301

002-0714-3522-012

FIRST ADDITION TO ROCKRIDGE SUBDIVISION

Property Owner KENN BLOCK

Parcel ID # LOT # 18

Page 2 of 4

24 Boring # Boring Pit Ground surface elev. 94.3 ft.

Depth to limiting factor _____ in.

Horizon	Depth In.	Dominant Color Munsell	Redox Description Qu. Sz. Cont. Color	Texture	Structure Gr. Sz. Sh.	Consistence	Boundary	Roots	Soil Application Rate GPD/ft ²	
									*Eff#1	*Eff#2
									1	0-9
2	9-31	10YR 4/4	—	scl	2msbk	mfr	CW	2m	0.4	0.6
3	31-84	10YR 6/4	—	sl	1mpl	mfr	—	2f	0.4	0.6

33 Boring # Boring Pit Ground surface elev. 93.2 ft.

Depth to limiting factor 84+ in.

Horizon	Depth In.	Dominant Color Munsell	Redox Description Qu. Sz. Cont. Color	Texture	Structure Gr. Sz. Sh.	Consistence	Boundary	Roots	Soil Application Rate GPD/ft ²	
									*Eff#1	*Eff#2
									1	0-10
2	10-20	7.5YR 4/4	—	scl	2msbk	mfr	CW	2m	0.4	0.6
3	20-84	10YR 6/4	—	sl	1mpl	mfr	—	2f	0.4	0.6

Boring # Boring Pit Ground surface elev. _____ ft.

Depth to limiting factor _____ in.

Horizon	Depth In.	Dominant Color Munsell	Redox Description Qu. Sz. Cont. Color	Texture	Structure Gr. Sz. Sh.	Consistence	Boundary	Roots	Soil Application Rate GPD/ft ²	
									*Eff#1	*Eff#2


* Effluent #1 = BOD₅ > 30 < 220 mg/L and TSS >30 < 150 mg/L * Effluent #2 = BOD₅ ≤ 30 mg/L and TSS ≤ 30 mg/L

The Department of Commerce is an equal opportunity service provider and employer. If you need assistance to access services or need material in an alternate format, please contact the department at 608-266-3151 or TTY 608-264-8777.


... certify that all slopes 20% or greater are shown and that all minimum continuous suitable soil areas for proposed mound systems are free of land slopes exceeding the percentages of Comm.85.04(4)(b)1a.b. Soil test elevations on the proposed lots are at the expected final grade for the subdivision.

Date 9-19-00
REV. 1-4-01
1-9-01

James B. Woodman
Professional Land Surveyor, S-1239

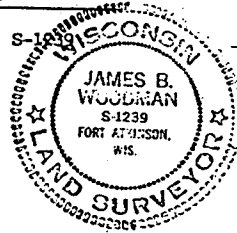


SOIL TEST INFO BY RICHARD C. HERRO
CST-71536 APRIL 21, 2001

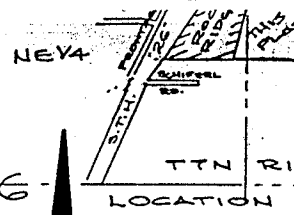


PAGE 3 OF 4

NOTE: Septic systems must maintain a 5' well on Lot 11. The owners of lots for maintaining the area on that

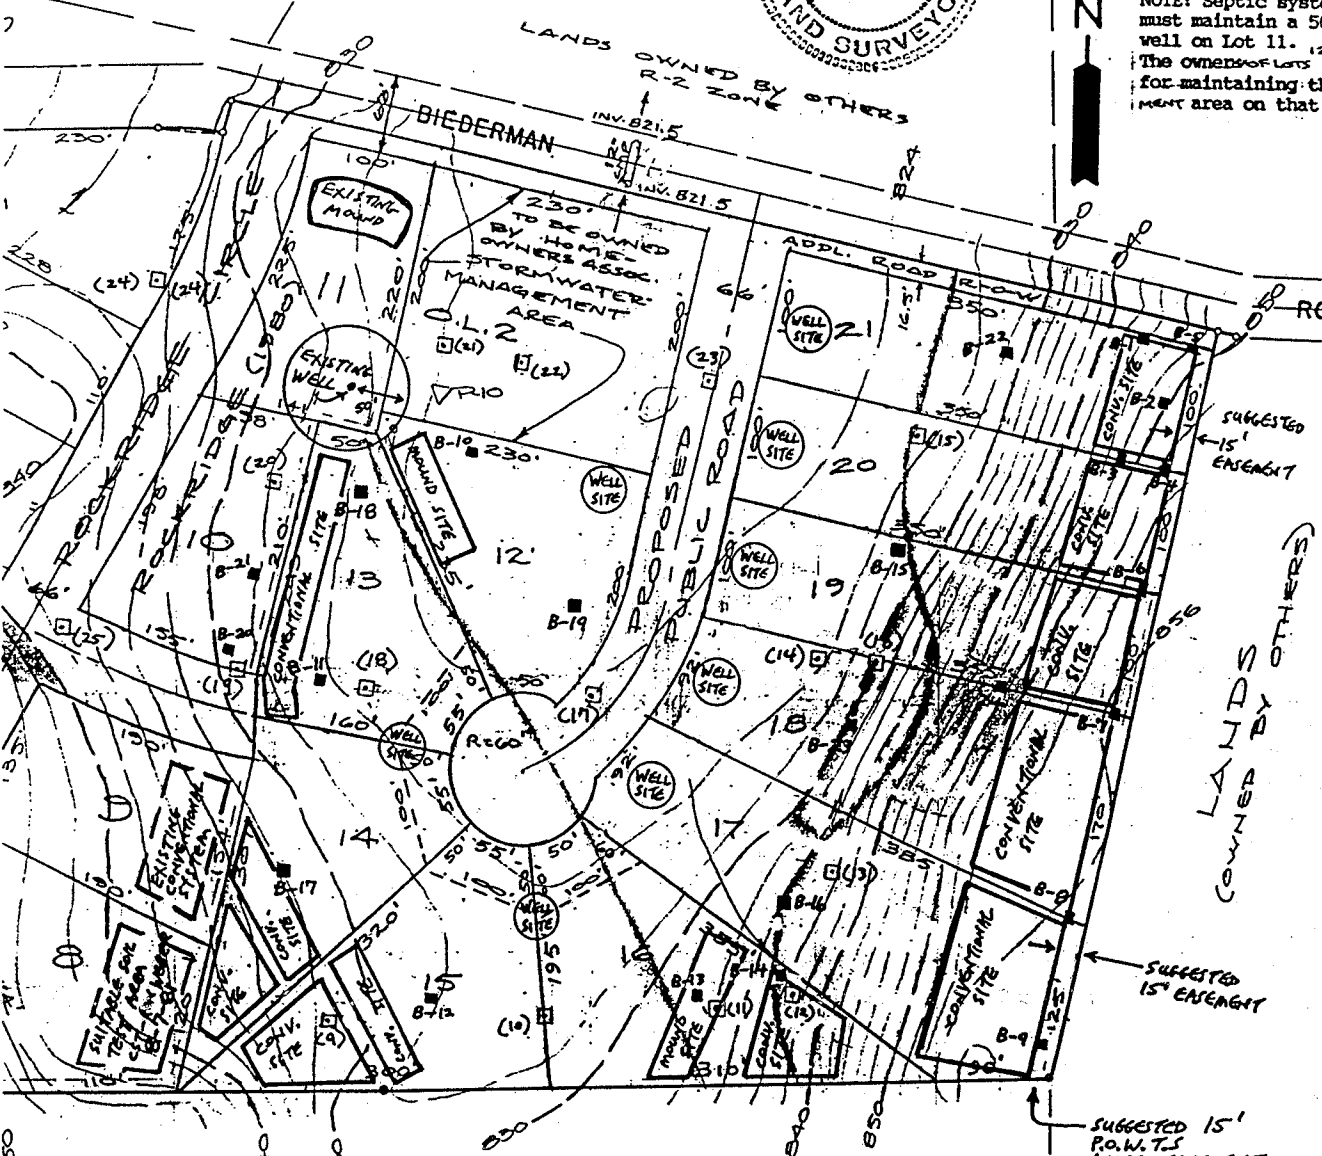

- SOIL BORING - 1999 AND 2001 (AND RE-LOG OF PREVIOUS SOIL BORINGS BY CST - RICK HERRO ON ADJOINING LOTS.)
- Soil Boring - 1979 (NUMBER)
- POTENTIAL SITE FOR WATER WELL.

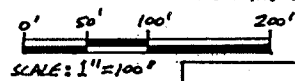

Total Area - 10.9 acres
Total Number of Lots - 1ST ADD. - 10 (LOTS 12-21)
Lot Sizes - 30,000 to 68,000 Sq. Ft.
Shaded Areas Indicate Slopes 20% or Greater
PRESENT ZONING - R-2 RES.

Owner/Developer
Kann Block
270 E. FIEL
OROVILLE,
525-575-

WOODMAN & ASSOCIATES
Professional Land Surveyors
210 MADISON AVENUE
FORT ATKINSON, WISCONSIN 53120
(608) 563-8162
FAX (608) 563-6654

JAMES B. WOODMAN
PROFESSIONAL LAND SURVEYOR

I certify that this Preliminary Plat, prepared in compliance with the subdivision regulations of Jefferson County, is a correct representation of all existing land divisions and features and that the slope delineations and soils test locations are accurately shown hereon to the best of my knowledge and belief.

Date 12-4-79
REV. 1-18-00
REV. 9-17-00
11-7-00 1-4-01
1-9-01

James B. Woodman
Registered Land Surveyor, S-1239

PRELIMINARY PLAT
FIRST ADD. TO R2
Part of Sections 25 & 26, T7N,
Town of Astalan, Jefferson County

DSN	DATE	REV.	DATE
JBW		12-4-79	
KF		1-16-80	
JBW	8/20/79	11-15-79	

1-18-00
9-19-00
11-7-00

TCS, INC.
W4570 Linmar Lane
P.O. Box 340
Johnson Creek, WI 53038

LOT NUMBER - 18

PAGE 4 OF 4.

SITE PLAN: KENN BLOCK = OWNER


DATE: APRIL 28, 2001

SCALE: 1" = 40'

NW 1/4 NW 1/4 SECTION 25, T 7 N, R 14 E, TOWNSHIP: AZTALAN

COUNTY: JEFFERSON, WI. FIRST ADDITION TO ROCKRIDGE SUBDIVISION

NOTE: LOT LINES AS SHOWN ARE AN ESTIMATE BASED ON PRELIMINARY PLAT.
EXACT AND PERMANENT LOT LINES TO BE SET BY LAND SURVEYOR.

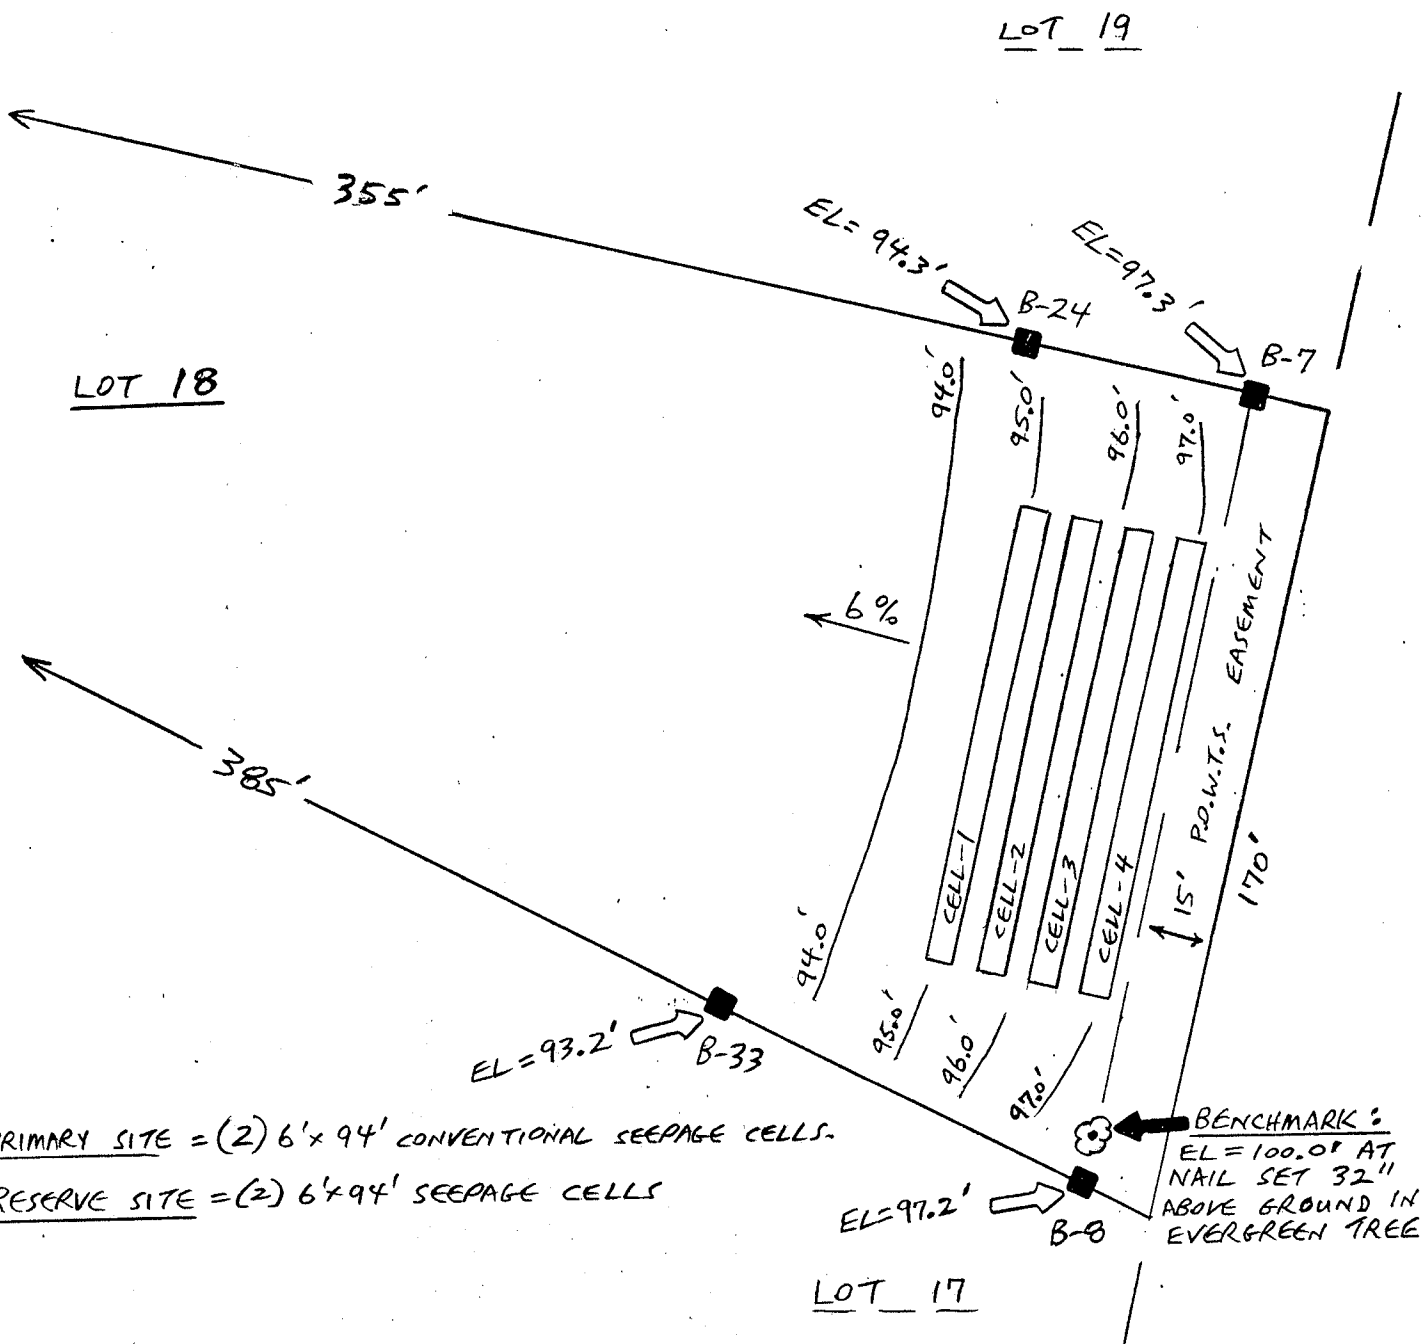

PRIMARY SITE = (2) 6' x 94' CONVENTIONAL SEEPAGE CELLS.

RESERVE SITE = (2) 6' x 94' SEEPAGE CELLS



SCS SOIL SURVEY MAP NO. _____ DELINEATES _____
DUPLICATE ORIGINAL DOCUMENTS SIGNED IN RED INK →
NOTE: NO WELLS WITHIN 50 FEET OF SOIL TEST SITE.

Richard C Herro
RICHARD C. HERRO CST-2694
CREDENTIAL # 71536