

in accordance with Comm 85, Wis. Adm. Code

Attach complete site plan on paper not less than 8 1/2 x 11 inches in size. Plan must include, but not limited to: vertical and horizontal reference point (BM), direction and percent slope, scale or dimensions, north arrow, and location and distance to nearest road.

Please print all information.

Personal information you provide may be used for secondary purposes (Privacy Law, s. 15.04 (1) (m)).

County	JEFFERSON
Parcel I.D.	002-0714-2522-013
Reviewed by	Date

Property Owner <b>KENN BLOCK</b>	Property Location Govt. Lot <b>NW 1/4 NW 1/4 S 25 T 7 N R 14 E 10A W</b>		
Property Owner's Mailing Address <b>270 E. FIELDCREST LANE</b>	Lot # <b>19</b>	Block #	Subd. Name or GSM# <b>FIRST ADDITION TO ROCKRIDGE</b>
City <b>ORO VALLEY</b>	State <b>AZ</b>	Zip Code <b>85737</b>	Phone Number <b>(520) 575-1340</b>
<input type="checkbox"/> City		<input type="checkbox"/> Village <input checked="" type="checkbox"/> Town	
		Nearest Road <b>AZTALAN BIEDERMAN ROAD</b>	

New Construction Use:  Residential / Number of bedrooms 3 Code derived design flow rate 450 GPD  
 Replacement  Public or commercial - Describe: \_\_\_\_\_  
 Parent material LOESS OVER GLACIAL TILL Flood Plain elevation if applicable NONE ft.

General comments and recommendations: INSTALL CONVENTIONAL SEEPAGE CELLS AS SHOWN ON SITE PLAN.  
SOIL APPLICATION RATE = 0.4 GPD/FT<sup>2</sup>

**6** Boring #  Boring  Pit Ground surface elev. 95.8 ft. Depth to limiting factor 84+ in.

Horizon	Depth In.	Dominant Color Munsell	Redox Description Qu. Sz. Cont. Color	Texture	Structure Gr. Sz. Sh.	Consistence	Boundary	Roots	Soil Application Rate GPD/ft <sup>2</sup>	
									*Eff#1	*Eff#2
									1	0-10
2	10-26	7.5YR 4/4	—	scl	2m sbk	mfr	CW	2m	0.4	0.5
3	26-84	10YR 6/4	—	sl	1mpl	mfr	—	2f	0.4	0.5

**7** Boring #  Boring  Pit Ground surface elev. 97.3 ft. Depth to limiting factor 84+ in.

Horizon	Depth In.	Dominant Color Munsell	Redox Description Qu. Sz. Cont. Color	Texture	Structure Gr. Sz. Sh.	Consistence	Boundary	Roots	Soil Application Rate GPD/ft <sup>2</sup>	
									*Eff#1	*Eff#2
									1	0-13
2	13-39	7.5YR 4/4	—	scl	2m sbk	mfr	CW	2m	0.4	0.5
3	39-84	10YR 6/4	—	sl	1mpl	mfr	—	2f	0.4	0.5

\* Effluent #1 = BOD<sub>5</sub> > 30 ≤ 220 mg/L and TSS > 30 ≤ 150 mg/L

\* Effluent #2 = BOD<sub>5</sub> ≤ 30 mg/L and TSS ≤ 30 mg/L

CST Name (Please Print) <b>RICHARD C. HERRO</b>	Signature <i>Richard C Herro</i>	CST Number <b>CREDENTIAL # 71536</b>
Address <b>603 N. DEWEY AVE., JEFFERSON, WI 53549</b>	Date Evaluation Conducted <b>4-28-2001</b>	Telephone Number <b>920-674-2301</b>

002-0714-2522-013

FIRST ADDITION TO ROCKRIDGE SUBDIVISION

Property Owner KENN BLOCK

Parcel ID # LOT # 19

Page 2 of 4

**24** Boring #  Boring  Pit Ground surface elev. 94.3 ft. Depth to limiting factor 84+ in.

Horizon	Depth In.	Dominant Color Munsell	Redox Description Qu. Sz. Cont. Color	Texture	Structure Gr. Sz. Sh.	Consistence	Boundary	Roots	Soil Application Rate	
									GPD/ft <sup>2</sup>	
									*Eff#1	*Eff#2
1	0-9	10YR 3/3	-	sil	2fsbk	mfr	CS	3m	0.5	0.8
2	9-31	10YR 4/4	-	scl	2msbk	mfr	CW	2m	0.4	0.6
3	31-84	10YR 6/4	-	sl	Impl	mfr	-	2f	0.4	0.6

**34** Boring #  Boring  Pit Ground surface elev. 92.4 ft. Depth to limiting factor 84+ in.

Horizon	Depth In.	Dominant Color Munsell	Redox Description Qu. Sz. Cont. Color	Texture	Structure Gr. Sz. Sh.	Consistence	Boundary	Roots	Soil Application Rate	
									GPD/ft <sup>2</sup>	
									*Eff#1	*Eff#2
1	0-10	10YR 3/3	-	sil	2fsbk	mfr	CS	3m	0.5	0.8
2	10-24	10YR 4/4	-	scl	2msbk	mfr	CW	2m	0.4	0.6
3	24-84	10YR 6/4	-	sl	Impl	mfr	-	2f	0.4	0.6

Boring #  Boring  Pit Ground surface elev. \_\_\_\_\_ ft. Depth to limiting factor \_\_\_\_\_ in.

Horizon	Depth In.	Dominant Color Munsell	Redox Description Qu. Sz. Cont. Color	Texture	Structure Gr. Sz. Sh.	Consistence	Boundary	Roots	Soil Application Rate	
									GPD/ft <sup>2</sup>	
									*Eff#1	*Eff#2


\* Effluent #1 = BOD<sub>5</sub> > 30 ≤ 220 mg/L and TSS > 30 ≤ 150 mg/L      \* Effluent #2 = BOD<sub>5</sub> ≤ 30 mg/L and TSS ≤ 30 mg/L

The Department of Commerce is an equal opportunity service provider and employer. If you need assistance to access services or need material in an alternate format, please contact the department at 608-266-3151 or TTY 608-264-8777.


greater are shown and that all minimum continuous suitable soil areas for proposed mound systems are free of land slopes exceeding the percentages of Comm.85.04(4)(b)1a-b. Soil test elevations on the proposed lots are at the expected final grade for the subdivision.

Date 9-19-00  
REV. 1-4-01  
1-9-01

James B. Woodman  
Professional Land Surveyor, S-1239

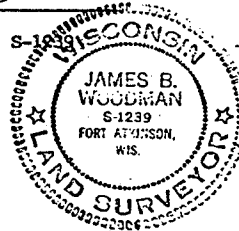


SOIL TEST INFO BY RICHARD C. HERRO  
CST-71536 APRIL 21, 2001

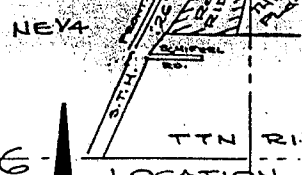


PAGE 3 OF 4

NOTE: Septic systems must maintain a 50' well on Lot 11. The owners of lots for maintaining the ment area on that

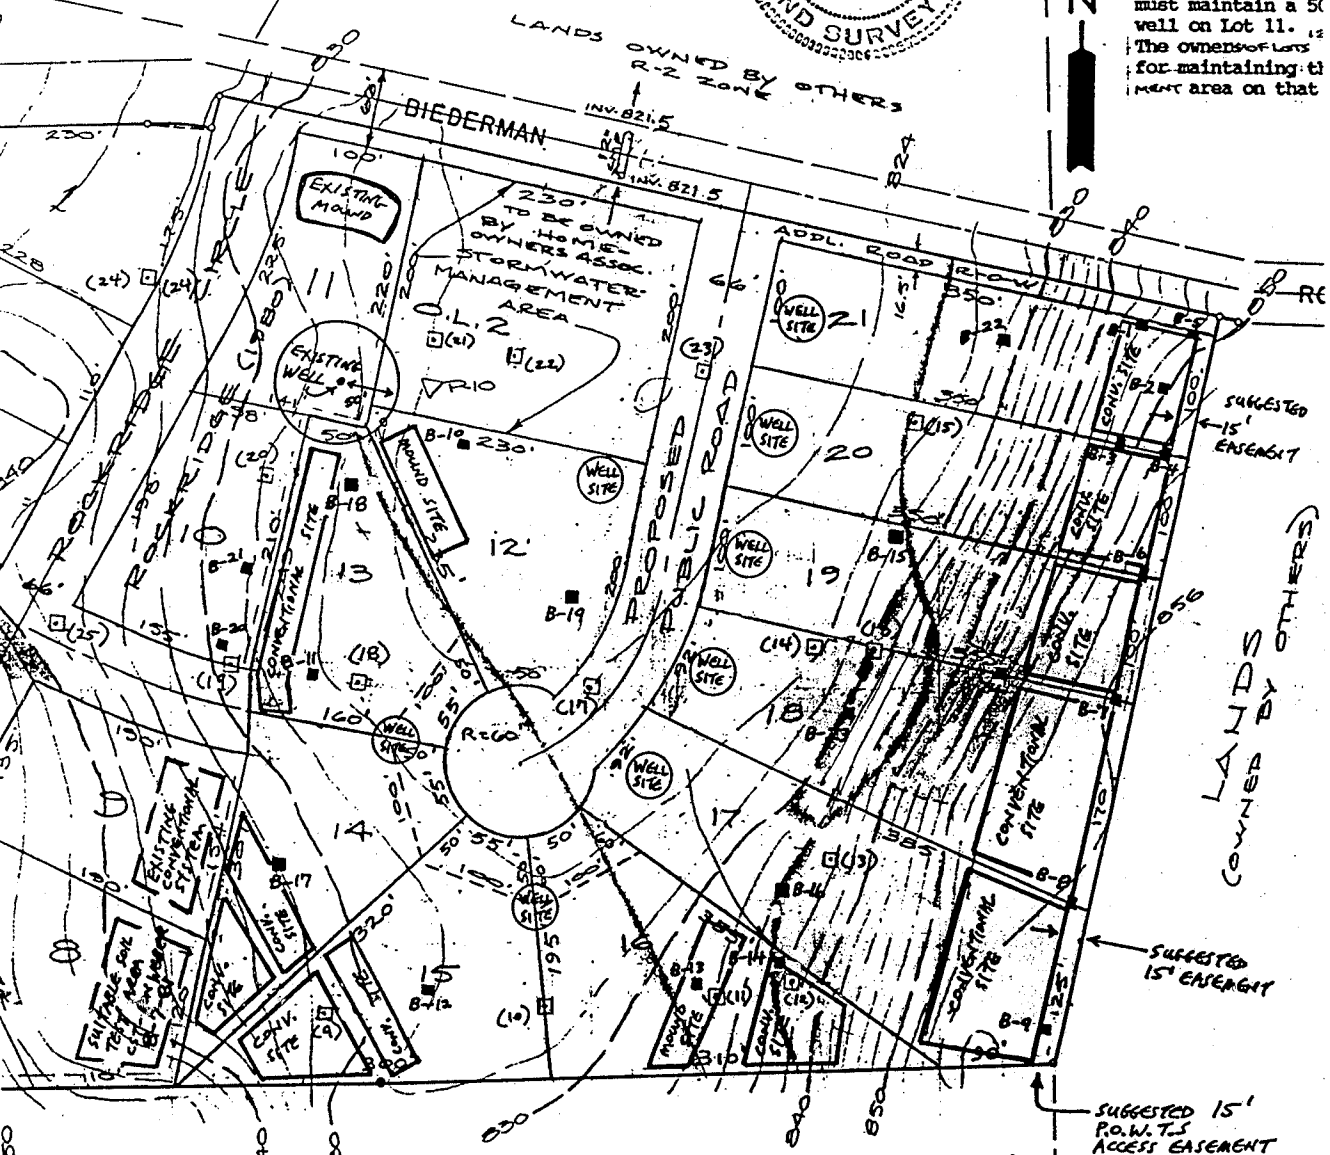

- SOIL BORING - 1999 NO 2001 (AND RE-LOG OF PREVIOUS SOIL BORINGS BY CST-RICK HEARD ON ADJOINING LOTS)
- Soil Boring - 1979 (NUMBER)
- POTENTIAL SITE FOR WATER WELL

Total Area - 10.9 acres  
Total Number of Lots - 1ST ADD. - 10 (LOTS 12-21)  
Lot Sizes - 30,000 to 60,000 Sq. Ft.  
Shaded Areas Indicate Slopes 20% or Greater  
PRESENT ZONING - R-2 RES.

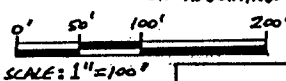

SUGGESTED 15' P.O.W.T.S ACCESS EASEMENT

Owner/Developer  
Kann Block  
270 E. FIE  
ORA VILLE  
520-575

I certify that this Preliminary Plat, prepared in compliance with the subdivision regulations of Jefferson County, is a correct representation of all existing land divisions and features and that the slope delineations and soils test locations are accurately shown hereon to the best of my knowledge and belief.

Date 12-4-79  
REV. 1-18-00  
REV. 9-19-00  
11-7-00 1-4-01  
1-9-01

James B. Woodman  
Registered Land Surveyor, S-1239

**WOODMAN & ASSOCIATES**  
Professional Land Surveyors  
210 MADISON AVENUE  
FORT ATKINSON, WISCONSIN 531  
(920) 563-6162  
FAX (920) 563-6654

PRELIMINARY PLAT  
FIRST ADD. TO R-2  
Part of Sections 25 & 26, T7N,  
Town of Aztalan, Jefferson County

DSN.	REV.	DATE
JBW	12-4-79	
KF	1-16-00	
JBW	11-15-79	8/20/79

TCS, INC.  
W4570 Linmar Lane  
P.O. Box 340  
Johnson Creek, WI 53038

LOT NUMBER - 19

PAGE 4 OF 4

SITE PLAN: KENN BLOCK = OWNER

DATE: APRIL 28, 2001

SCALE: 1" = 40'


NW 1/4 NW 1/4 SECTION 25, T 7 N, R 14 E, TOWNSHIP: AZTALAN

COUNTY: JEFFERSON, WI. FIRST ADDITION TO ROCKRIDGE SUBDIVISION

NOTE: LOT LINES AS SHOWN ARE AN ESTIMATE BASED ON PRELIMINARY PLAT.  
EXACT AND PERMANENT LOT LINES TO BE SET BY LAND SURVEYOR.

PRIMARY SITE = (3) 6' x 63' CONVENTIONAL SEEPAGE CELLS.

RESERVE SITE = (3) 6' x 63' SEEPAGE CELLS.

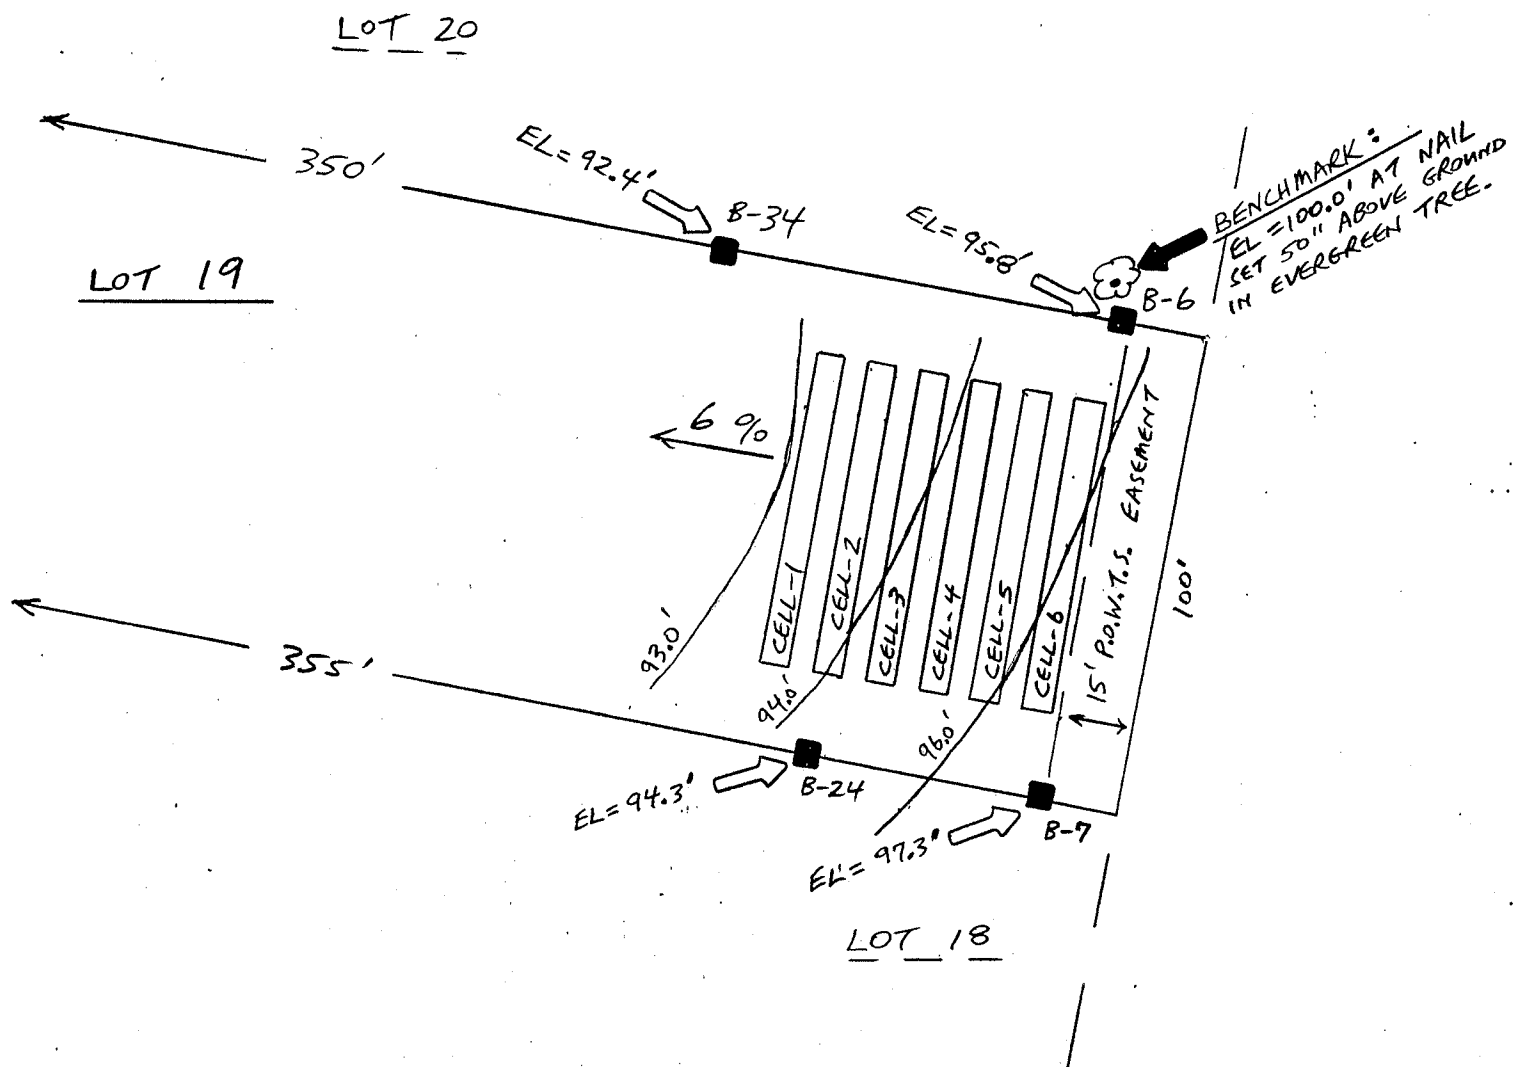

SCS SOIL SURVEY MAP NO. \_\_\_\_\_ DELINEATES \_\_\_\_\_  
DUPLICATE ORIGINAL DOCUMENTS SIGNED IN RED INK  
NOTE: NO WELLS WITHIN 50 FEET OF SOIL TEST SITE.

*Richard C Herro*  
RICHARD C. HERRO CST-2694  
CREDENTIAL # 71536